

FIRST FLOOR - COMMON AREA

UNIT 100 - FIRST FLOOR 838 SQ. FT.

UNIT 101 - FIRST FLOOR 922 SQ. FT.

UNIT 102 - FIRST FLOOR 929 SQ. FT.

UNIT 103 - FIRST FLOOR 927 SQ. FT.

UNIT 104 - FIRST FLOOR 685 SQ. FT.

UNIT 105 - FIRST FLOOR 926 SQ. FT.

 COMMON AREA - FLDOR AREA

 BASEMENT
 6,400 SQ, FT

 FIRST FLOOR
 1,060 SQ, FT

 SECOND FLOOR
 992 SQ, FT


 THIRD FLOOR
 992 SQ, FT

 FOURTH FLOOR
 963 SQ, FT

TOTAL: 10,407 SQ. FT.

FLOOR PLANS

Scale: 3/16" = 1'-0"

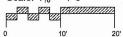



= Common Area

--- -1

= Unit Access

----- = Unit Separation Wall

Reserved for Registry Use


FIRST FLOOR

SCALE: 3/16" = 1'-0"

693 Western Ave Condominium

693 Western Ave, Lynn, Massachusetts 01905 August 29, 2019 I hareby certify that this plan shows the unit designation of the unit being conveyed and of immediately adjoining units, and that it fully and accurately depicts the layout of the unit, its location, unit number and dimensions of the units numbered 100, 101, 102, 103, 104, 105, 200, 201, 202, 203, 204, 205, 300, 301, 302, 303, 304, 305, 401, 402, 403, 404, 4, 405 as built, approximate area, main entrance and immediate common area to which it has access, in building at 693 Western Ave as built, and that this plan has been prepared in accordance with the Registry of Deeds and the Commonwealth of

SHEET 2 OF 5

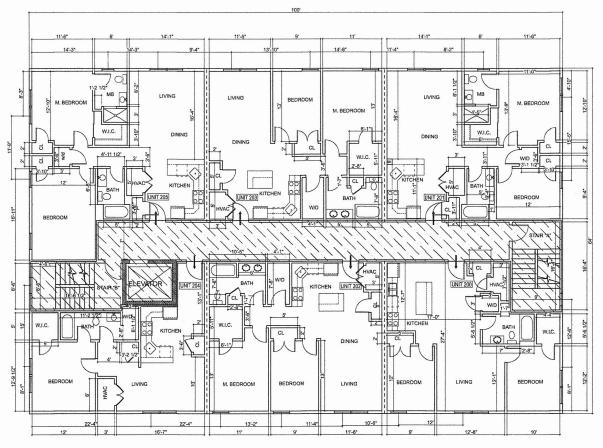

SECOND FLOOR - COMMON AREA
992 SQ. FT.

UNIT 200 - SECOND FLOOR
836 SQ. FT.

UNIT 201 - SECOND FLOOR
926 SQ. FT.

UNIT 202 - SECOND FLOOR
929 SQ. FT.

UNIT 203 - SECOND FLOOR
927 SQ. FT.


UNIT 204 - SECOND FLOOR
685 SQ. FT.

UNIT 205 - SECOND FLOOR
1,021 SQ. FT.

BASEMENT	6,400 SQ. F
FIRST FLOOR	1,060 SQ. F
SECOND FLOOR	992 SQ. FT
THIRD FLOOR	992 SQ. FT
FOURTH FLOOR	963 SQ, F1

FLOOR PLANS

Scale: 3/16" = 1'-0"

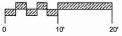

1//

= Common Area

→ = Unit Access

----- = Unit Separation Wall


SECOND FLOOR

SCALE: 3/16" = 1'-0"

693 Western Ave Condominium

693 Western Ave, Lynn, Massachusetts 01905 August 29, 2019 I hereby certify that this plan shows the unit designation of the unit being conveyed and of immediately adjoining units, and that it fully and accurately depicts the layout of the unit, its location, unit number and dimensions of the units numbered 100, 101, 102, 103, 140, 105, 200, 201, 202, 203, 204, 205, 300, 301, 302, 303, 304, 305, 401, 402, 403, 404, 405 as built, approximate area, main entrance and immediate common area to which it has access, in building at 638 Western Ave as built, and that this plan has been prepared in accordance with the Registry of Deeds and the Commonwealth of Massachusetts.

Reserved for Registry Use

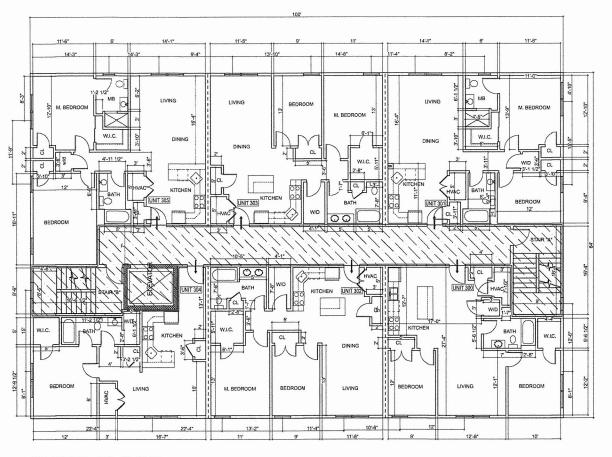

THIRD FLOOR - COMMON AREA
992 SQ. FT.

UNIT 300 - THIRD FLOOR
838 SQ. FT.

UNIT 301 - THIRD FLOOR
928 SQ. FT.

UNIT 302 - THIRD FLOOR
929 SQ. FT.

UNIT 303 - THIRD FLOOR
927 SQ. FT.

UNIT 304 - THIRD FLOOR
685 SQ. FT.

UNIT 305 - THIRD FLOOR
1,021 SQ. FT.

FLOOR PLANS

Scale: 3/16" = 1'-0"

0 10' 20'

1//

= Common Area

→ = Unit Access

----- = Unit Separation Wall


THIRD FLOOR

SCALE: 3/16" = 1'-0"

693 Western Ave Condominium

693 Western Ave, Lynn, Massachusetts 01905 August 29, 2019 I hereby certify that this plan shows the unit designation of the unit being conveyed and of immediately adplining units, and that If fully and accurately depicts the layout of the unit, its localism, unit number and dimensions of the units numbered 100, 101, 102, 103, 140, 1405, 200, 201, 202, 203, 204, 205, 300, 301, 305, 302, 303, 304, 305, 401, 402, 403, 404, 405 as built, approximate area, main entrance and immediate cermon area to which it has access, in building at 693 Western Ave as built, and that this plan has been prepared in accordance with the Registry of Deeds and the Commonwealth of Massachusetts.

Reserved for Registry Use

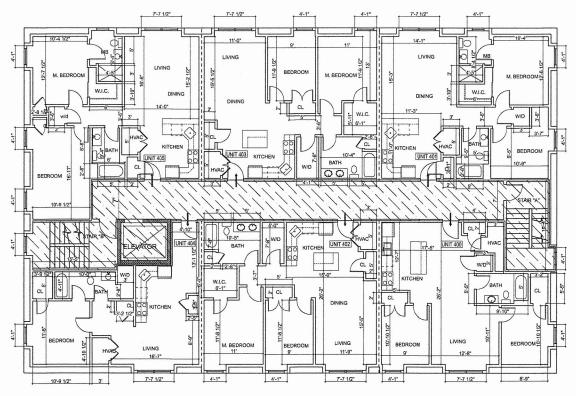

FOURTH FLOOR

SCALE: 3/16" = 1'-0"

FOURTH FLOOR - COMMON AREA 963 SQ. FT.

UNIT 400 - FOURTH FLOOR

UNIT 401 - FOURTH FLOOR 884 SQ. FT.

UNIT 402 - FOURTH FLOOR 911 SQ. FT.

UNIT 403 - FOURTH FLOOR

UNIT 404 - FOURTH FLOOR

UNIT 405 - FOURTH FLOOR 976 SQ. FT.

COMMON AREA - FLOOR AREA BASEMENT 6,400 SQ. FT.


FIRST FLOOR 1,060 SQ, FT. SECOND FLOOR 992 SQ. FT.

THIRD FLOOR FOURTH FLOOR 992 SQ. FT. 963 SQ. FT.

TOTAL: 10,407 SQ. FT.

FLOOR PLANS

Scale: $\frac{3}{16}$ " = 1'-0"

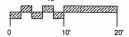

= Common Area

= Unit Access

----- = Unit Separation Wall

Reserved for Registry Use

693 Western Ave Condominium

693 Western Ave, Lynn, Massachusetts 01905 August 29, 2019

I hereby certify that this plan shows the unit designation of the unit being conveyed and of immediately adjoining units, and that it fully and accurately depicts the layout of the unit, its location, unit number and dimensions of the units numbered 100, 101, 102, 103, 104, 105, 200, 201, 202, 203, 204, 205, 300, 301, 302, 303, 304, 305, 401, 402, 403, 404, & 405 as built, approximate area, main entrance and immediate common area to which it has access, in building at 693 Western Ave as built, and that this plan has been prepared in accordance with the Registry of Deeds and the Commonwealth of Massachusetts.